


THIS DRAWING IS THE EXCLUSIVE PROPERTY OF APPLIED COMPRESSION SYSTEMS AND SHALL NOT BE REPRODUCED WITHOUT WRITTEN PERMISSION FROM ACS

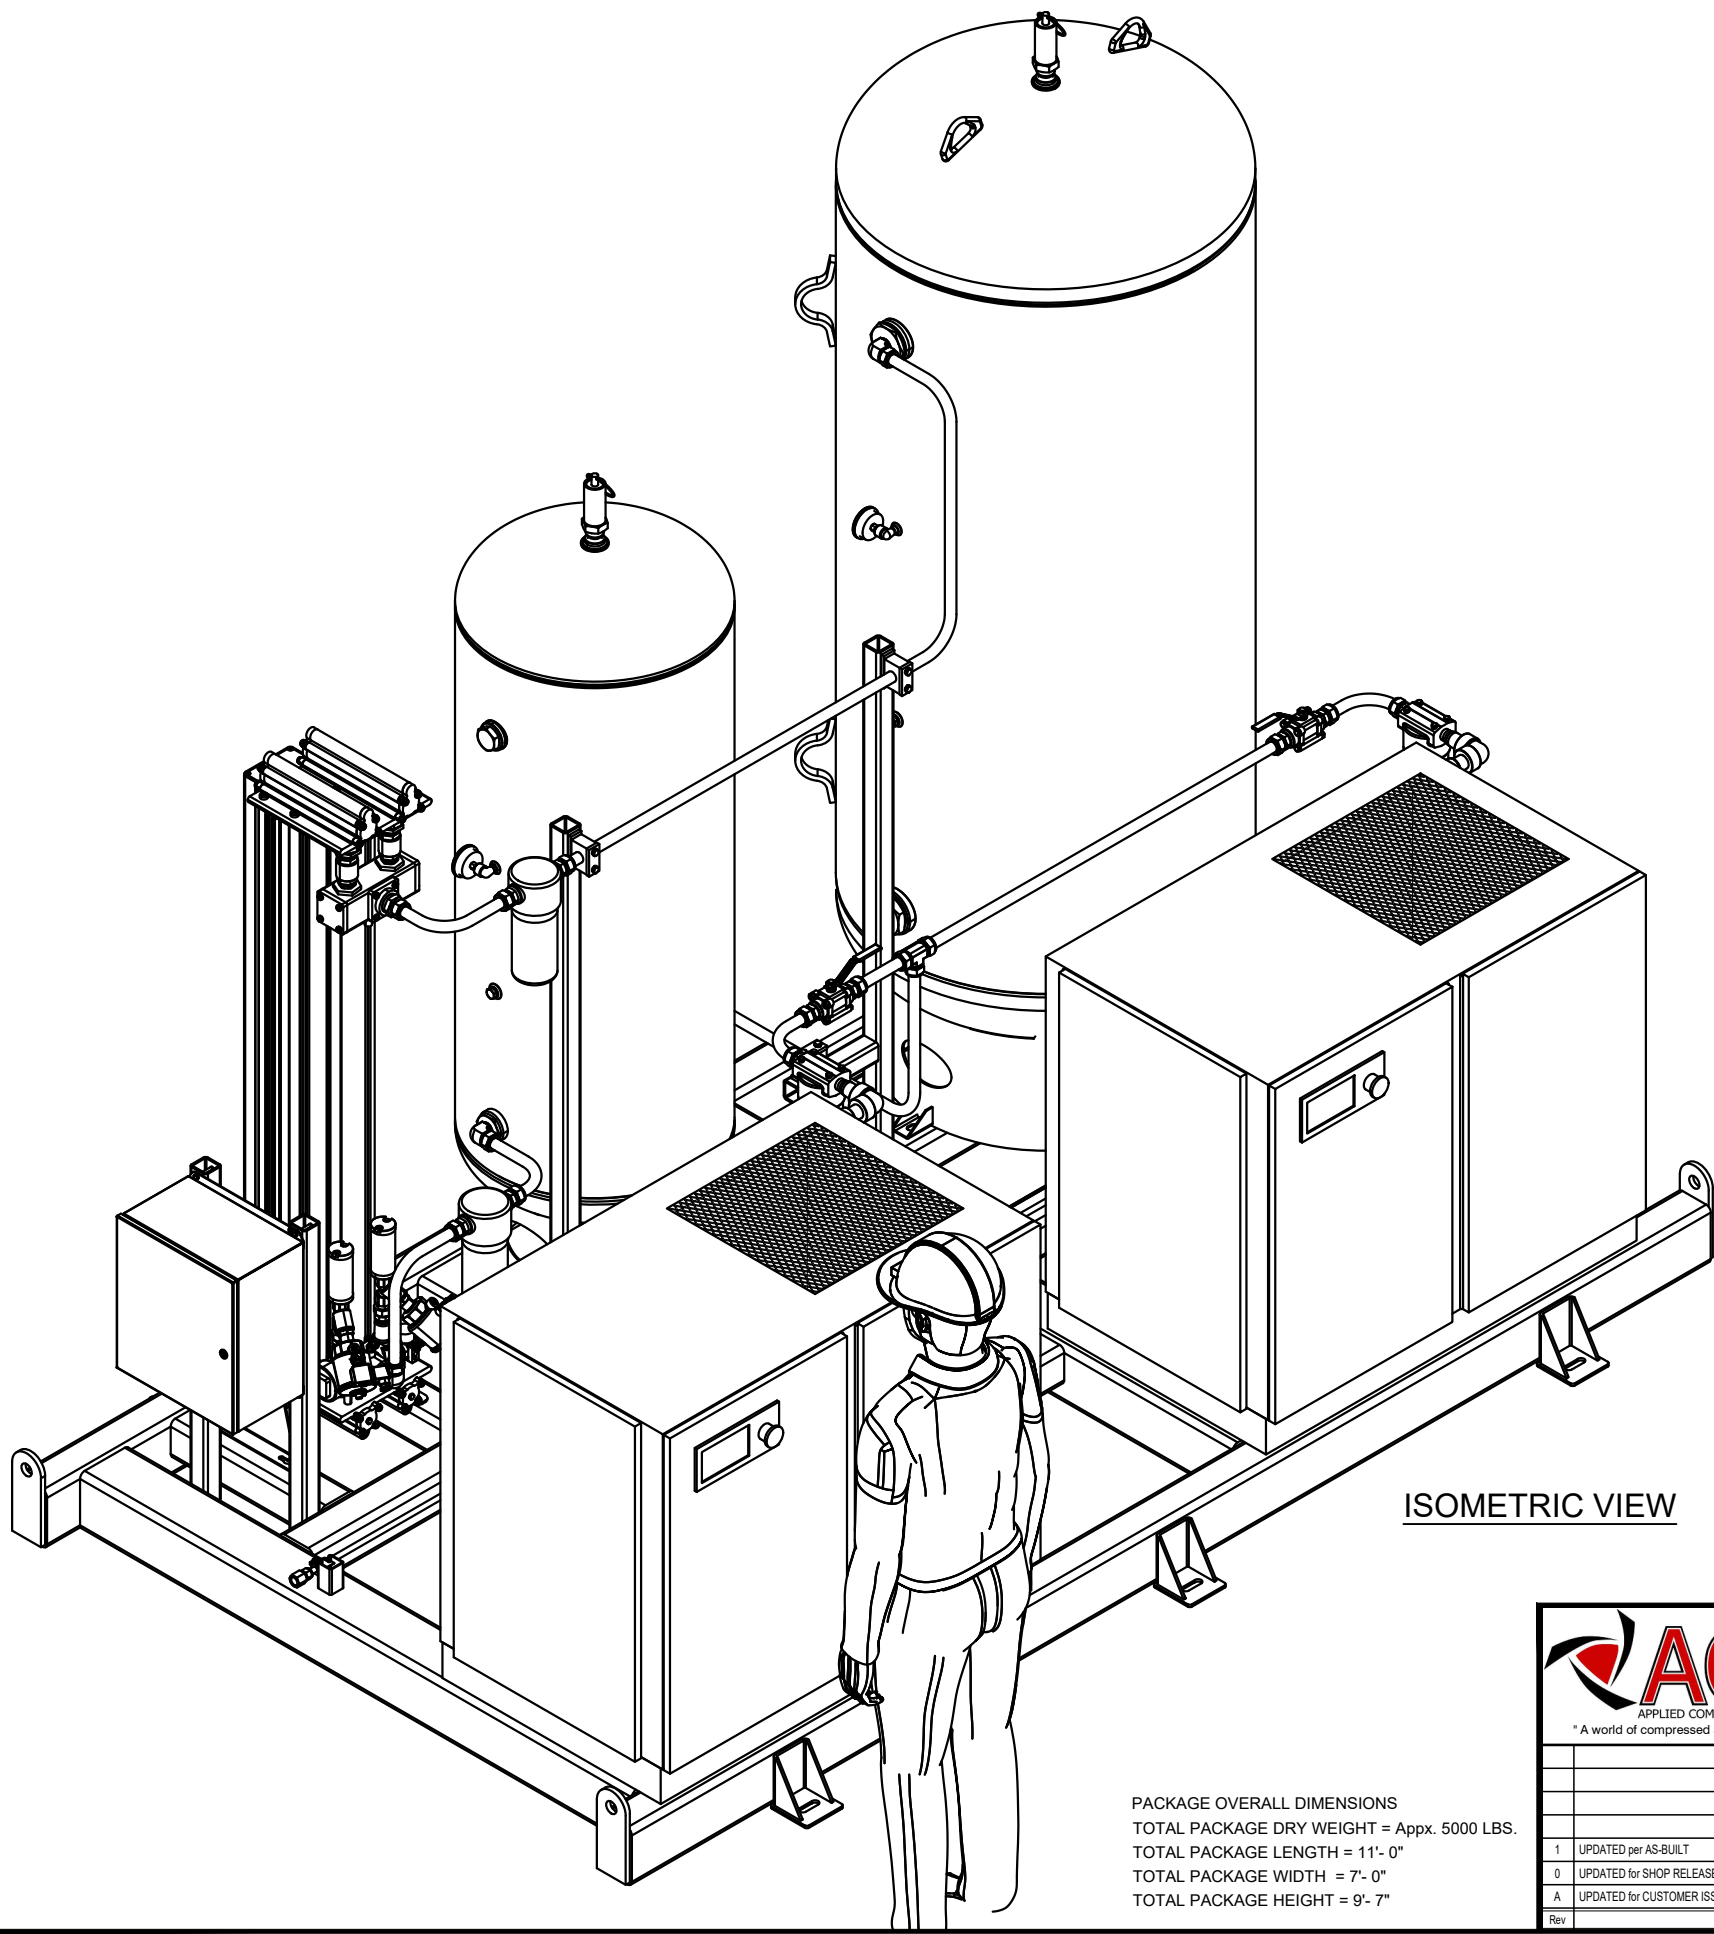

ISOMETRIC VIEW

AS-BUILT

PACKAGE OVERALL DIMENSIONS
TOTAL PACKAGE DRY WEIGHT = Appx. 5000 LBS.
TOTAL PACKAGE LENGTH = 11'- 0"
TOTAL PACKAGE WIDTH = 7'- 0"
TOTAL PACKAGE HEIGHT = 9'- 7"



ACS
 APPLIED COMPRESSION SYSTEMS
 " A world of compressed air and gas solutions "

400 Industrial Road "A"
 Cranbrook, British Columbia. V1C 4Z3
 Canada
 Ph: (250) 417 - 2396
 Fx: (250) 417 - 3183
 www.appliedcompression.com

Customer:

ENCORE COMBUSTION

Project:

VECTOR 3100 (DUPLEX) INSTR AIR COMP. PACKAGE
15 HP ELEC DRIVE RVD11H ROTARY VANE

Description:

GENERAL ASSEMBLY ISOMETRIC REFERENCE VIEW

Location:

AUSTIN, Texas

Job #:

ACJ-10272F

Tag #:

-

Cust PO:

P10946

Dwn By:

TB

Date:

MAR 16/22

Qty Recd:

ONE

Chk By:

NC

Date:

MAR 17/22

Scale:

3/4" = 1'- 0" (at 11 x 17)

App By:

MS

Date:

MAR 18/22

Dwg #:

GA-10272F-D

Rev:

1

--	--	